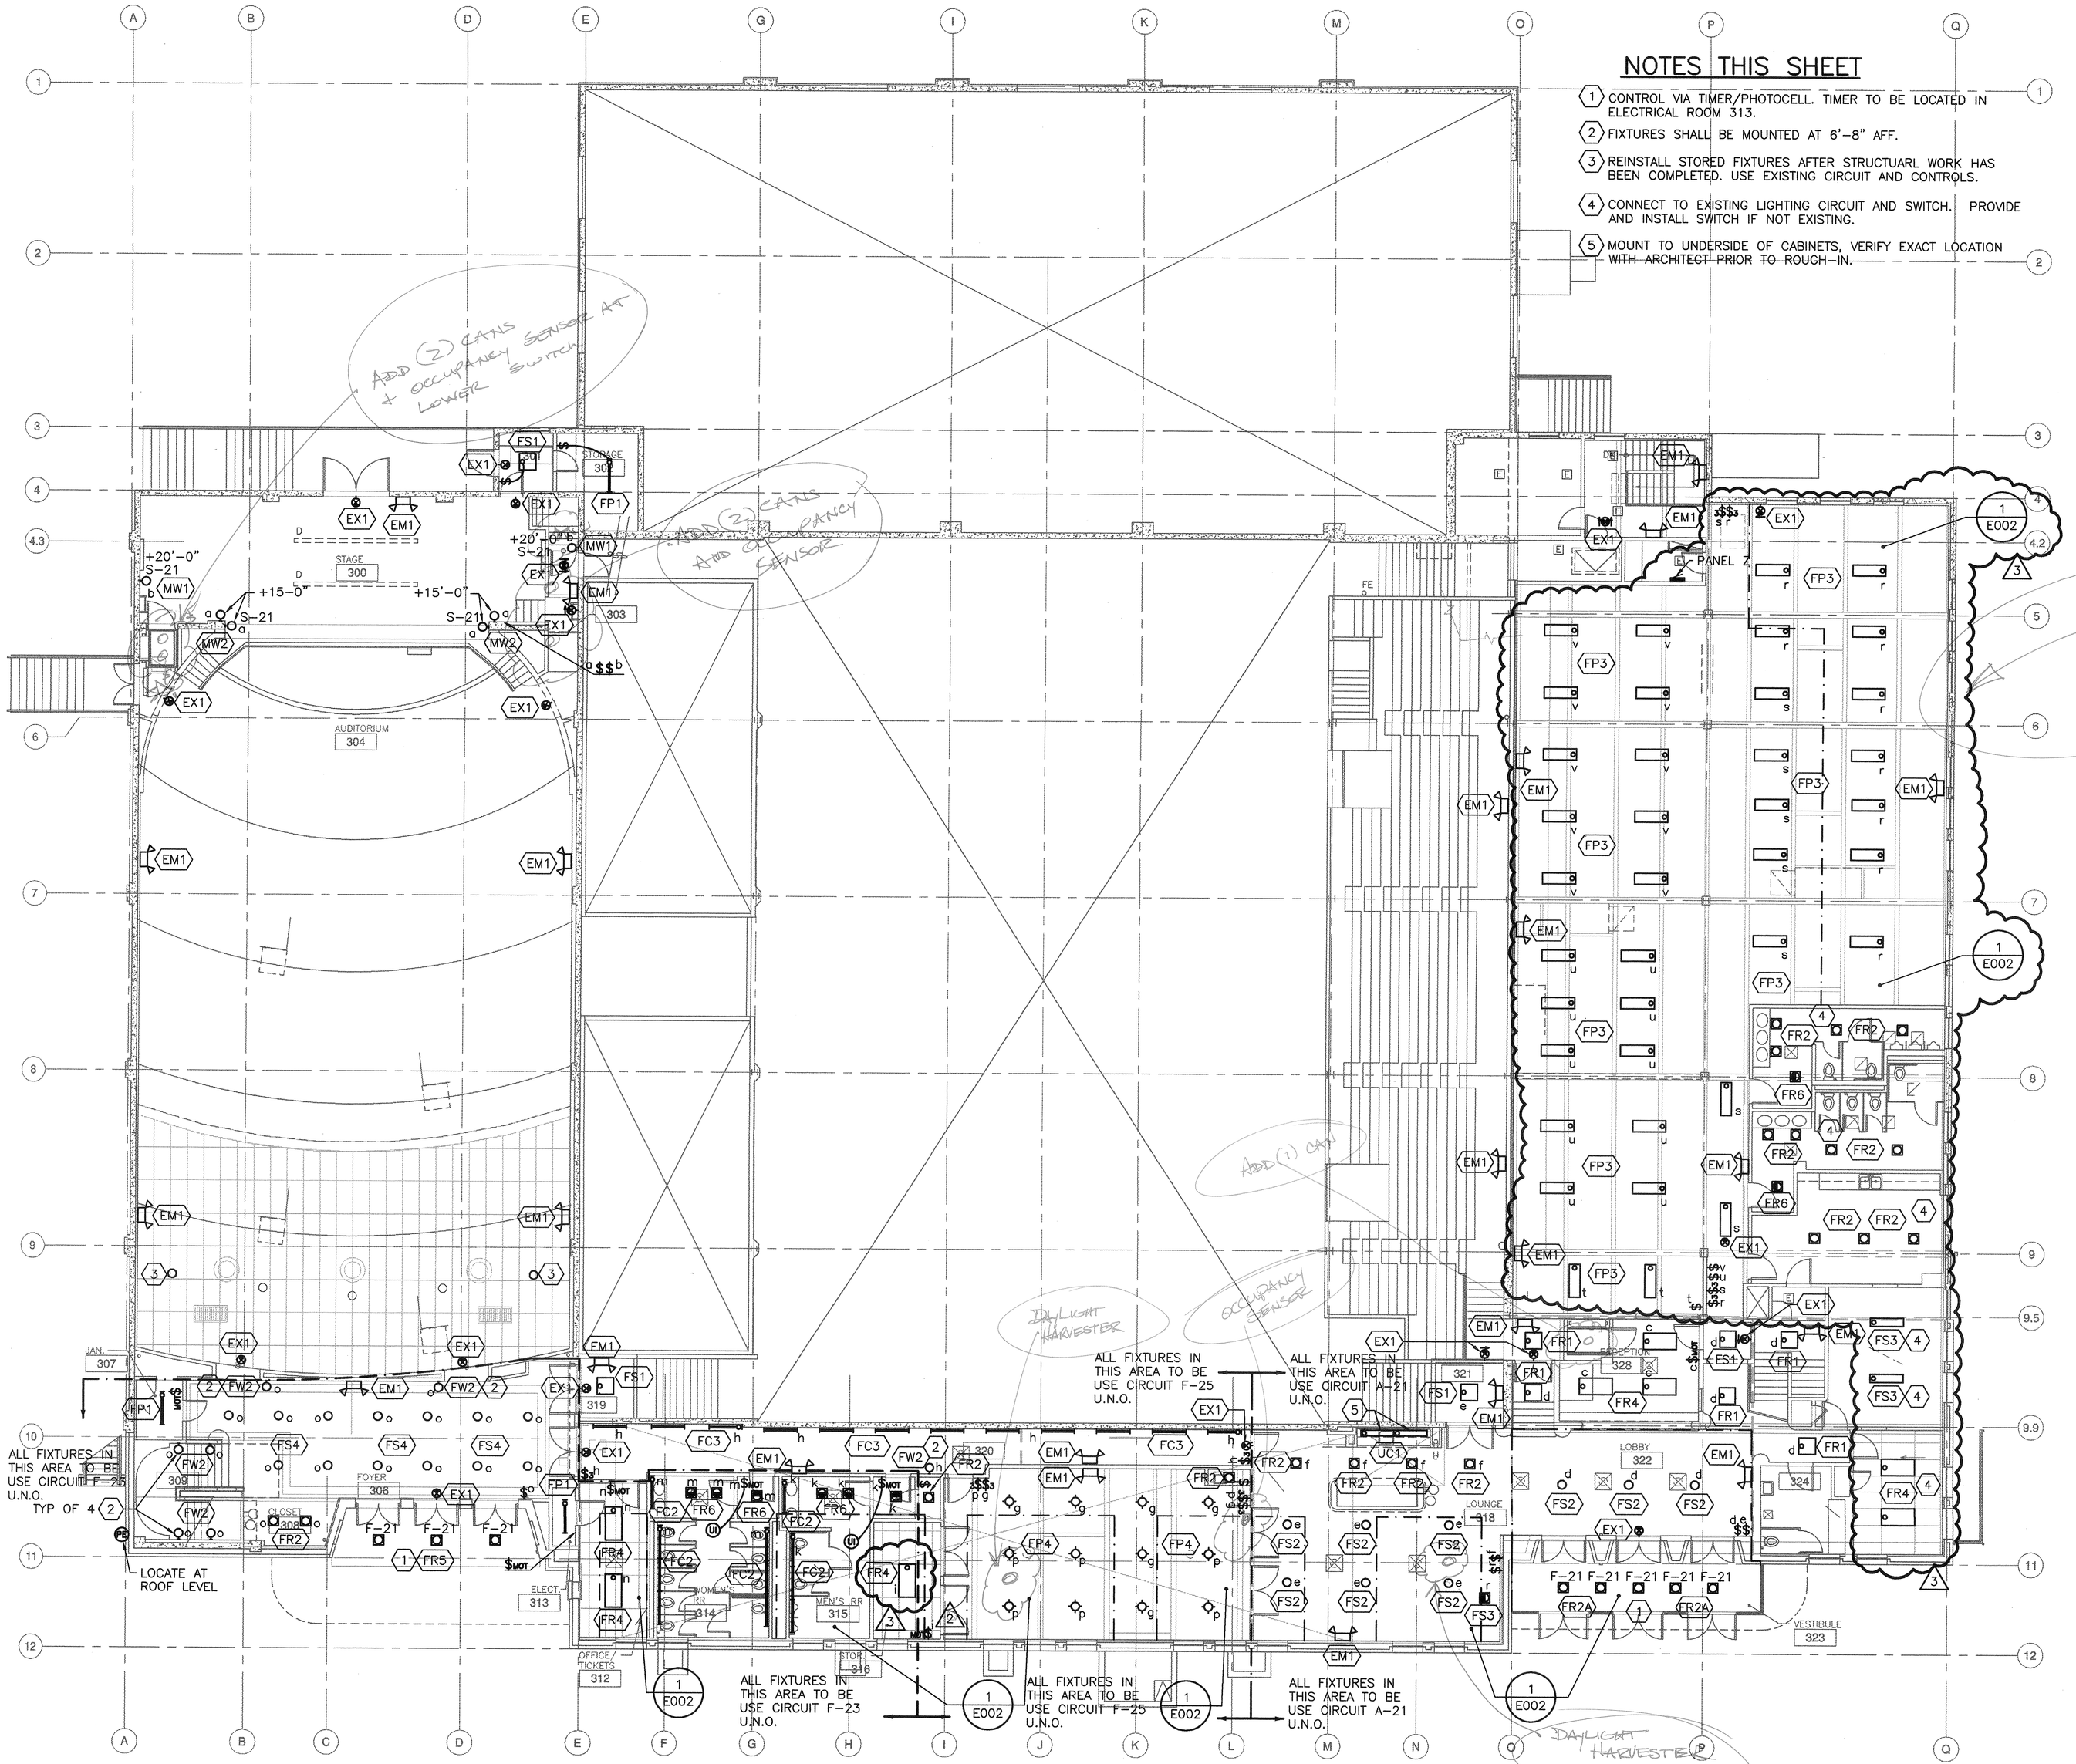

NOTES THIS SHEET

1. CONTROL VIA TIMER/PHOTOCELL. TIMER TO BE LOCATED IN ELECTRICAL ROOM 313.
2. FIXTURES SHALL BE MOUNTED AT 6'-8" AFF.
3. REINSTALL STORED FIXTURES AFTER STRUCTUARL WORK HAS BEEN COMPLETED. USE EXISTING CIRCUIT AND CONTROLS.
4. CONNECT TO EXISTING LIGHTING CIRCUIT AND SWITCH. PROVIDE AND INSTALL SWITCH IF NOT EXISTING.
5. MOUNT TO UNDERSIDE OF CABINETS, VERIFY EXACT LOCATION WITH ARCHITECT PRIOR TO ROUGH-IN.

GENERAL NOTES

1. RECORD DRAWINGS ARE MISSING FOR THIS FLOOR, ALL EXISTING ELECTRICAL INFORMATION IS FROM FIELD OBSERVATIONS.
2. ALL EXIT AND EMERGENCY EGRESS LIGHT FIXTURES SHALL BE CIRCUITED TO NEAREST LIGHTING CIRCUIT VIA UNSWITCHED LEG.
3. ALL EMERGENCY EGRESS LIGHT FIXTURES SHALL BE MOUNTED AT 8'-0" AFF OR 1'-0" BELOW CEILING, WHICH EVER IS LOWEST.

ARAI/JACKSON Architects & Planners
1601 East John • Seattle, WA 98112
Tel: 206-323-8800 Fax: 206-323-8518

CONSTRUCTION DOCUMENTS

NO.	REVISION – AS BUILT	DATE
3		
2	RFI #171	6/06/03
1	PERMIT CORRECTIONS 1	7/15/02

REVIEWED: PARK ENGINEER DATE

All work done in accordance with the City of Seattle Standard Plans and Specifications in effect on the date shown above, and supplemented by Special Provisions.

PATH ENGINEERS, LLC
17928 BOTHELL EVERETT HWY SE, SUITE H
BOTHELL, WASHINGTON 98012
(425) 481-7735 FAX (425) 481-7692
CONTACT: FRANK STARR
JOB NUMBER: 003261

SAND POINT
MAGNUSON PARK
COMMUNITY RECREATION CENTER

MAIN FLOOR
LIGHTING PLAN

DESIGNED	FHS	DATE	JULY 1, 2003
DRAWN	MDW	DESIGN REVIEW	
CHECKED	LDB		
ORDINANCE NO. 119812 & 119987			
CONTRACT NO. 1616		SHEET 69 OF 76	
SCALE 1/8" = 1'-0"			

MAIN FLOOR LIGHTING PLAN

SCALE: 1/8" = 1'-0"

NORTH

PLOT DATE:JULY 1, 2003

E202